
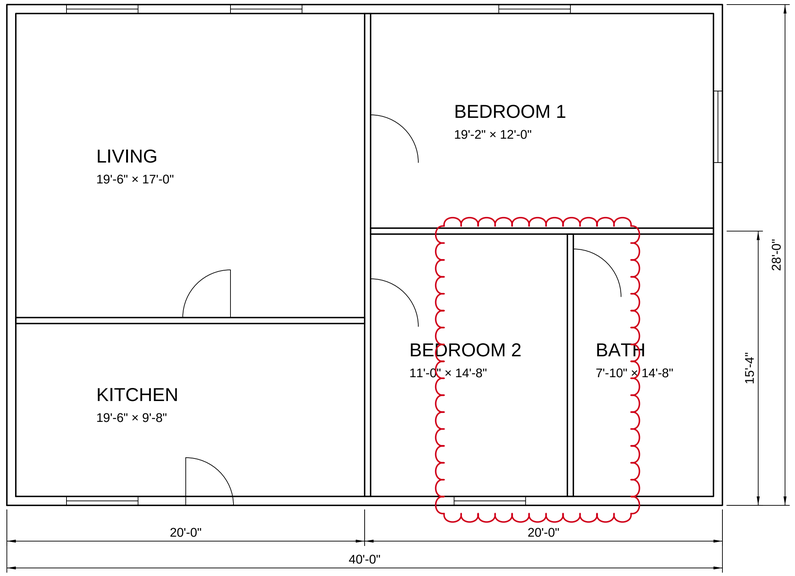


FLOOR PLAN

SCALE: 1/4" = 1'-0"


PROJECT SAMPLE HOUSE FLOOR PLAN	SCALE 1/4" = 1'-0" DATE 2026-10-05 REV B	DRAWN BY CADCRAFT	SHEET A-101

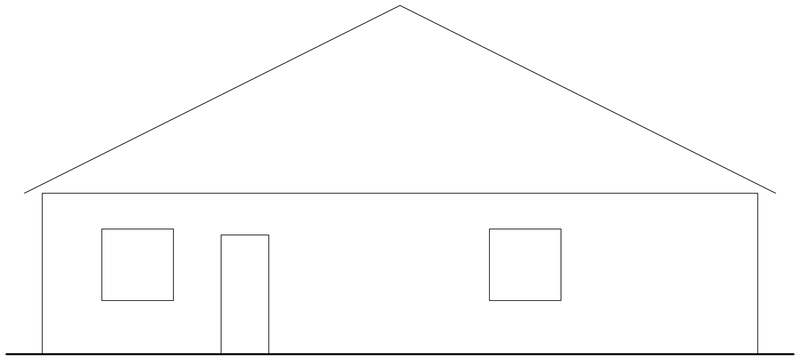

FRONT ELEVATION

SCALE: 1/4" = 1'-0"


PROJECT	SCALE	DRAWN BY	SHEET
SAMPLE HOUSE FRONT ELEVATION	1/4" = 1'-0" DATE 2026-10-05 REV B	CADCRAFT	A-201

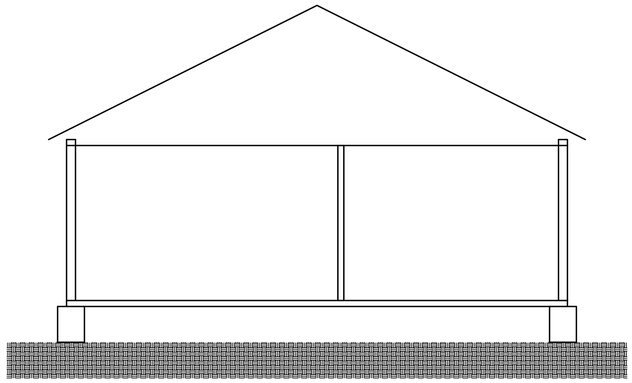

SECTION A-A

SCALE: 1/4" = 1'-0"

PROJECT SAMPLE HOUSE SECTION A-A	SCALE 1/4" = 1'-0" DATE 2026-10-05 REV B	DRAWN BY CADCRAFT	SHEET A-301

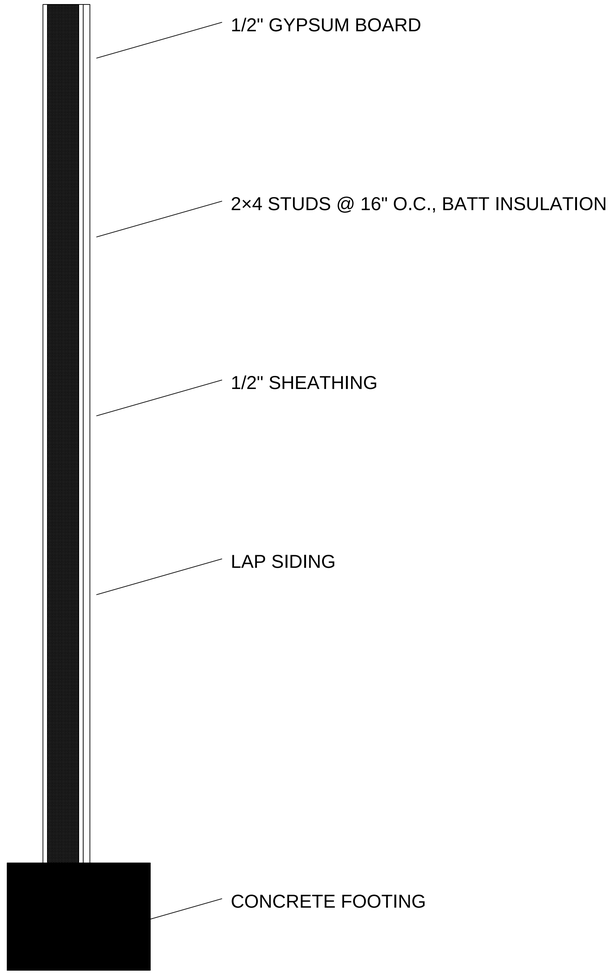

WALL DETAIL

SCALE: 1 1/2" = 1'-0"

PROJECT	SCALE	DRAWN BY	SHEET
SAMPLE HOUSE WALL DETAIL	1 1/2" = 1'-0" DATE 2026-10-05 REV B	CADCRAFT	A-501